

WILDLIFE AND COUNTRYSIDE ACT 1981  
FORM OF APPLICATION FOR MODIFICATION ORDER

To: East Sussex County Council  
of: County Hall, St. Anne's Crescent

I Alan Olin of Oakhurst (formerly the police house) Blacklands Brede Lane Sedlescombe East Sussex TN33 0PS hereby apply for an order under section 53(2) of the Wildlife and Countryside Act 1981 modifying the definitive map and statement for the area by adding the footpath from footpath 2B to Brede Lane and shown on the map accompanying this application.

I attach copies of the following documentary evidence (including statements of witnesses) in support of this application:

Signed: Alan Olin Dated: 21 Jan '14

WILDLIFE AND COUNTRYSIDE ACT 1981  
FORM OF APPLICATION FOR MODIFICATION ORDER


To: East Sussex County Council  
of: County Hall, St. Anne's Crescent

I Alan Olin of Oakhurst (formerly the police house) Blacklands Brede Lane Sedlescombe East Sussex hereby apply for an order under section 53(2) of the Wildlife and Countryside Act 1981 modifying the definitive map and statement for the area by adding the footpath from the intersection of footpath 2C and 3 to Brede Lane and shown on the map accompanying this application.

I attach copies of the following documentary evidence (including statements of witnesses) in support of this application:

Signed: .....  ..... Dated: ..... 7 Jan '14 .....  
The signature is handwritten in black ink and appears to read 'A. Olin'. The date is also handwritten in black ink and reads '7 Jan '14'.



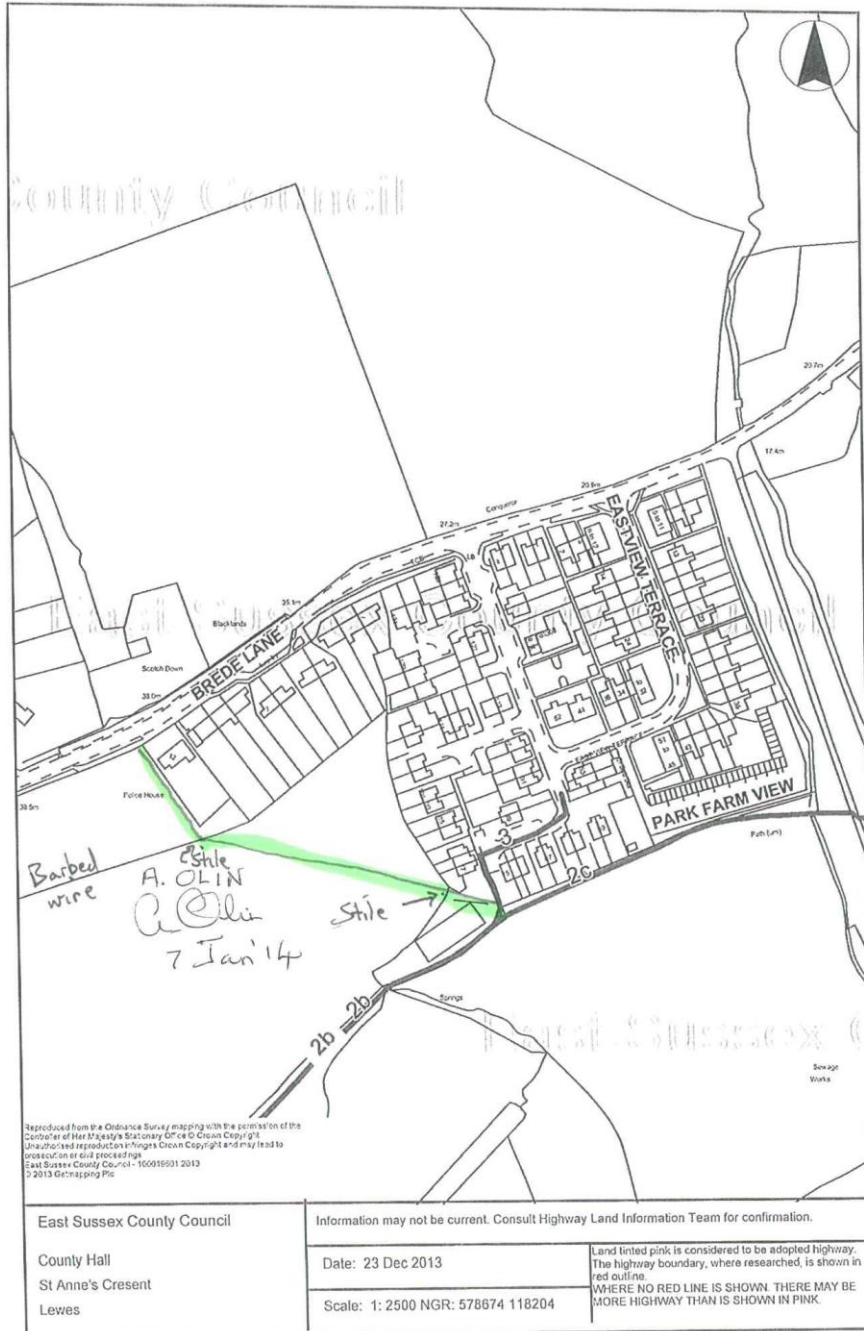

<p>East Sussex County Council</p>	<p>Information may not be current. Consult Highway Land Information Team for confirmation.</p>	
<p>County Hall</p>	<p>Date: 23 Dec 2013</p>	<p>Land tinted pink is considered to be adopted highway. The highway boundary, where researched, is shown in red outline.</p>
<p>St Anne's Crescent Lewes</p>	<p>Scale: 1: 2500 NGR: 578674 118204</p>	<p>WHERE NO RED LINE IS SHOWN THERE MAY BE MORE HIGHWAY THAN IS SHOWN IN PINK.</p>